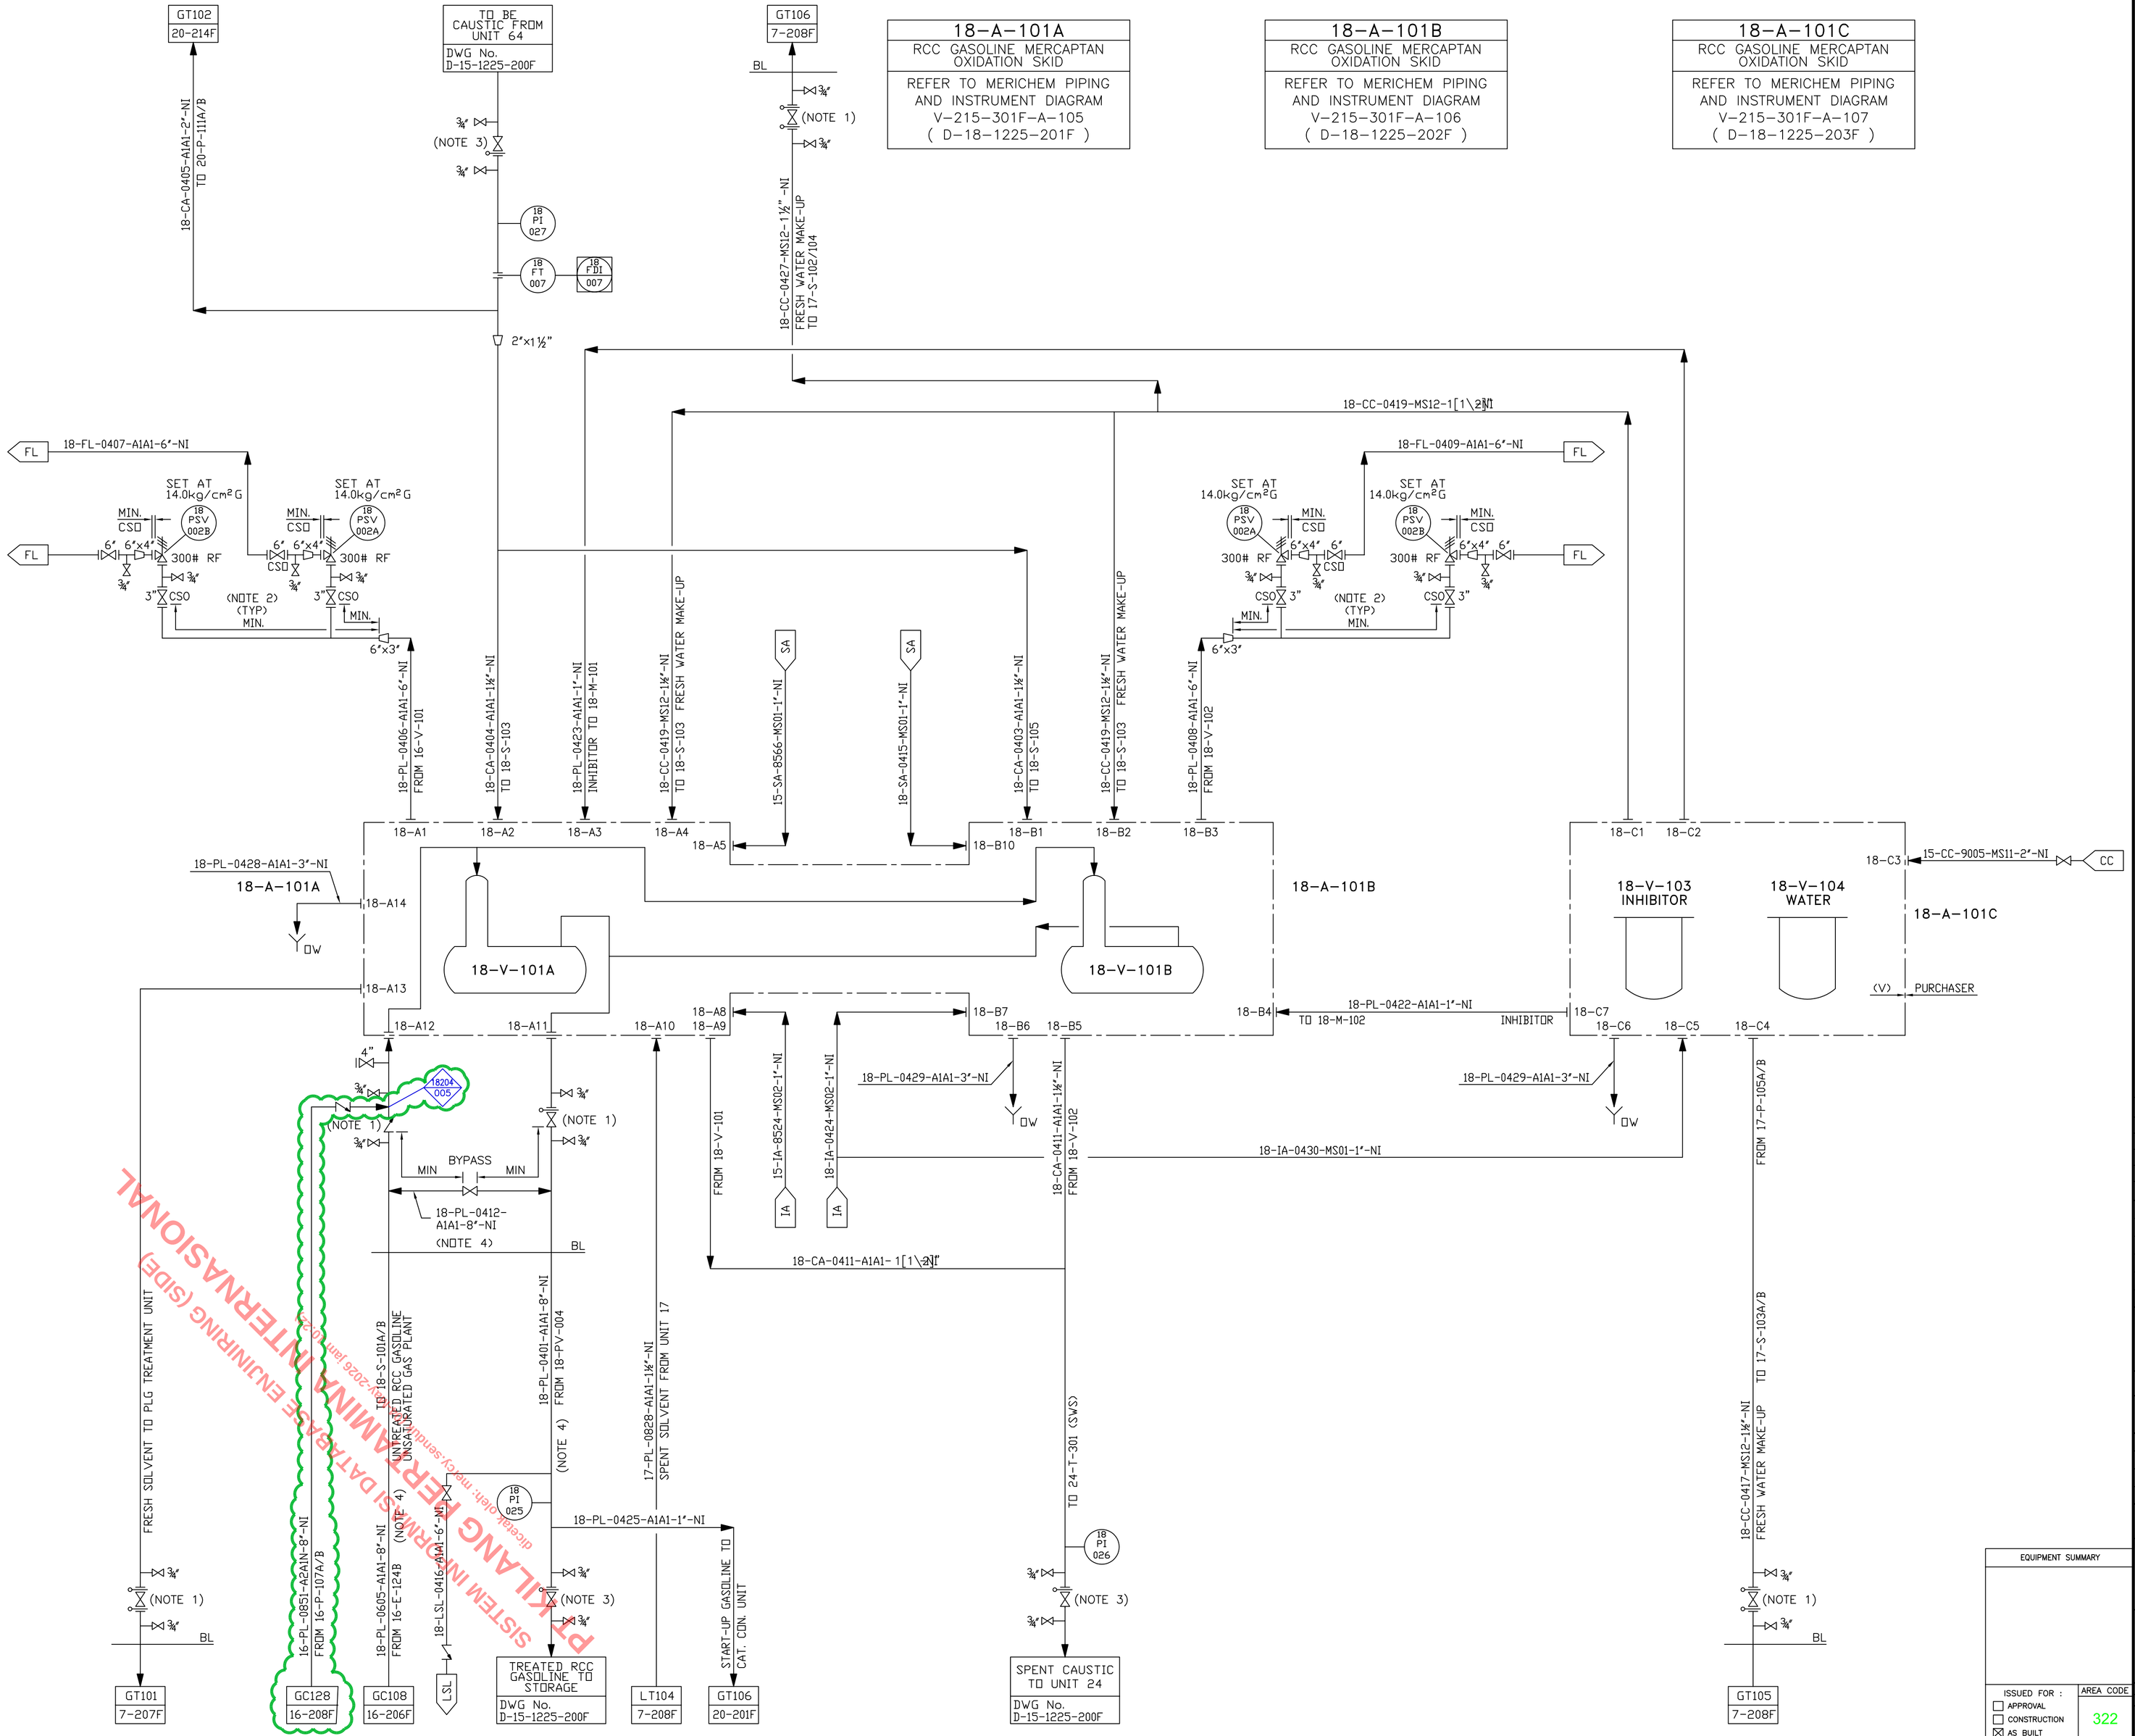

FOR GENERAL NOTES & SYMBOLS, SEE DWG No. D-00-1225-201/202J

FOR LINE LIST SEE DOCUMENT No. S-15-1360-007F

1. LOCATE VALVE /BLIND AT UNIT 18 BATTERY LIMIT.
2. PSV'S AND BY-PASS VALVES TO BE SUPPLIED LOOSE BY MERICHEM.
3. LOCATE AT RCC BATTERY LIMIT.
4. DURING RCC START-UP THIS LINE WILL BE USED IN REVERSE DIRECTION FOR GASOLINE IMPORT.

CLOUD NOTES

- REPLACEMENT MODIFICATION
- NEW ADD.
- CLEANING

LEGEND FOR PERTAMINA REVAMP PHASE II PROJECT:

- SCOPE OF WORK
- TIE-IN POINT (DWG No. XXXX, TIE-IN SEQUENCE No. YY)
- REMOVAL TIE-IN POINT (DWG No. XXXX, TIE-IN SEQUENCE No. YYR)

REFERENCE DRAWING

NO.	DWG. NO.	DESCRIPTION
1	D-18-1225-204F	JGC

REVISIONS

No.	DESCRIPTION	DRW. DATE	CHK. DATE	APP. DATE	CLIENT DATE
3	ISSUED FOR AS BUILT	YSA 09-12-08	DT 11-12-08	SPF 12-12-08	
2	ISSUED FOR CONSTRUCTION	YSA 09-03-08	DT 11-03-08	SPF 12-03-08	
1	ISSUED FOR APPROVAL	YSA 07-01-08	DT 09-01-08	SPF 12-01-08	
0	ISSUED FOR REVIEW	YSA 09-11-07	DT 12-09-11-07	SPF	

CONSORTIUM

PT. REKAYASA INDUSTRI — PT. JGC INDONESIA

CONTRACT NO. 1106/C00000/2007-SO — CONTRACTOR JOB NO. 07-1711/0-0519-05-0000

THIS DRAWING EMBODIES PROPRIETARY INFORMATION OF PT. REKAYASA INDUSTRI AND PT. JGC INDONESIA. THIS DRAWING OR THE MATERIAL DESCRIBED THEREON MAY NOT BE COPIED OR DISCLOSED IN ANY FORM OR MEDIUM TO THIRD PARTIES, OR USED FOR OTHER THAN THE PURPOSE FOR WHICH IT HAS BEEN PROVIDED, IN WHOLE OR IN PART IN ANY MANNER EXCEPT AS EXPRESSLY PERMITTED BY PT. REKAYASA INDUSTRI AND PT. JGC INDONESIA.

REVISIONS

JGC CORPORATION — FOSTER WHEELER

EQUIPMENT SUMMARY

ISSUED FOR : ☐ APPROVAL ☐ CONSTRUCTION ☒ AS BUILT

AREA CODE 322

TITLE : PIPING & INSTRUMENT DIAGRAM R.C.C. GASOLINE TREATMENT UNIT FACILITY CODE 18 INTERFACE

PT PERTAMINA (PERSERO)

EPC REVAMPING RCC UNIT PHASE - II KILANG UP VI BALONGAN

DRW'N	CHK'D	APP'D	SCALE
XX / DATE XX	XX / DATE XX	XX / DATE XX	NONE

DWG No. D-18-1225-204F-RP2-M-J — SIZE B — REV. 3

CAD FILE : D-18-1225-204F-RP2-M-J

DISTRIBUTION

PN: KPP-JKT, KPP-BAL, UP-VI

REK: HEAD OFFICE, PM, PCM, PROC MGR, CONSTR MGR, HSE MGR, QA/QC MGR, ADMIN MGR, PROCESS, MECHANICAL, CIVIL, PIPING, ELECTRICAL, INSTRUMENT, DOC CONTROL; SITE OFFICE, CONST MGR, CONST CTRL, CHIEF FIELD, CHIEF ISSUES, CHIEF QA/QC, CHIEF ADM, PROCESS SI, MECHANICAL SI, CIVIL SI, PIPING SI, ELECTRICAL SI, INSTRUMENT SI

JID: PJI, PJII, ENG MGR, PROCESS, CIVIL, PIPING, MECH, ROTARY, INSTR, ELECT, QA, DHT

D-18-1225-204F-RP2-M-J